

Area to be revised marked up below

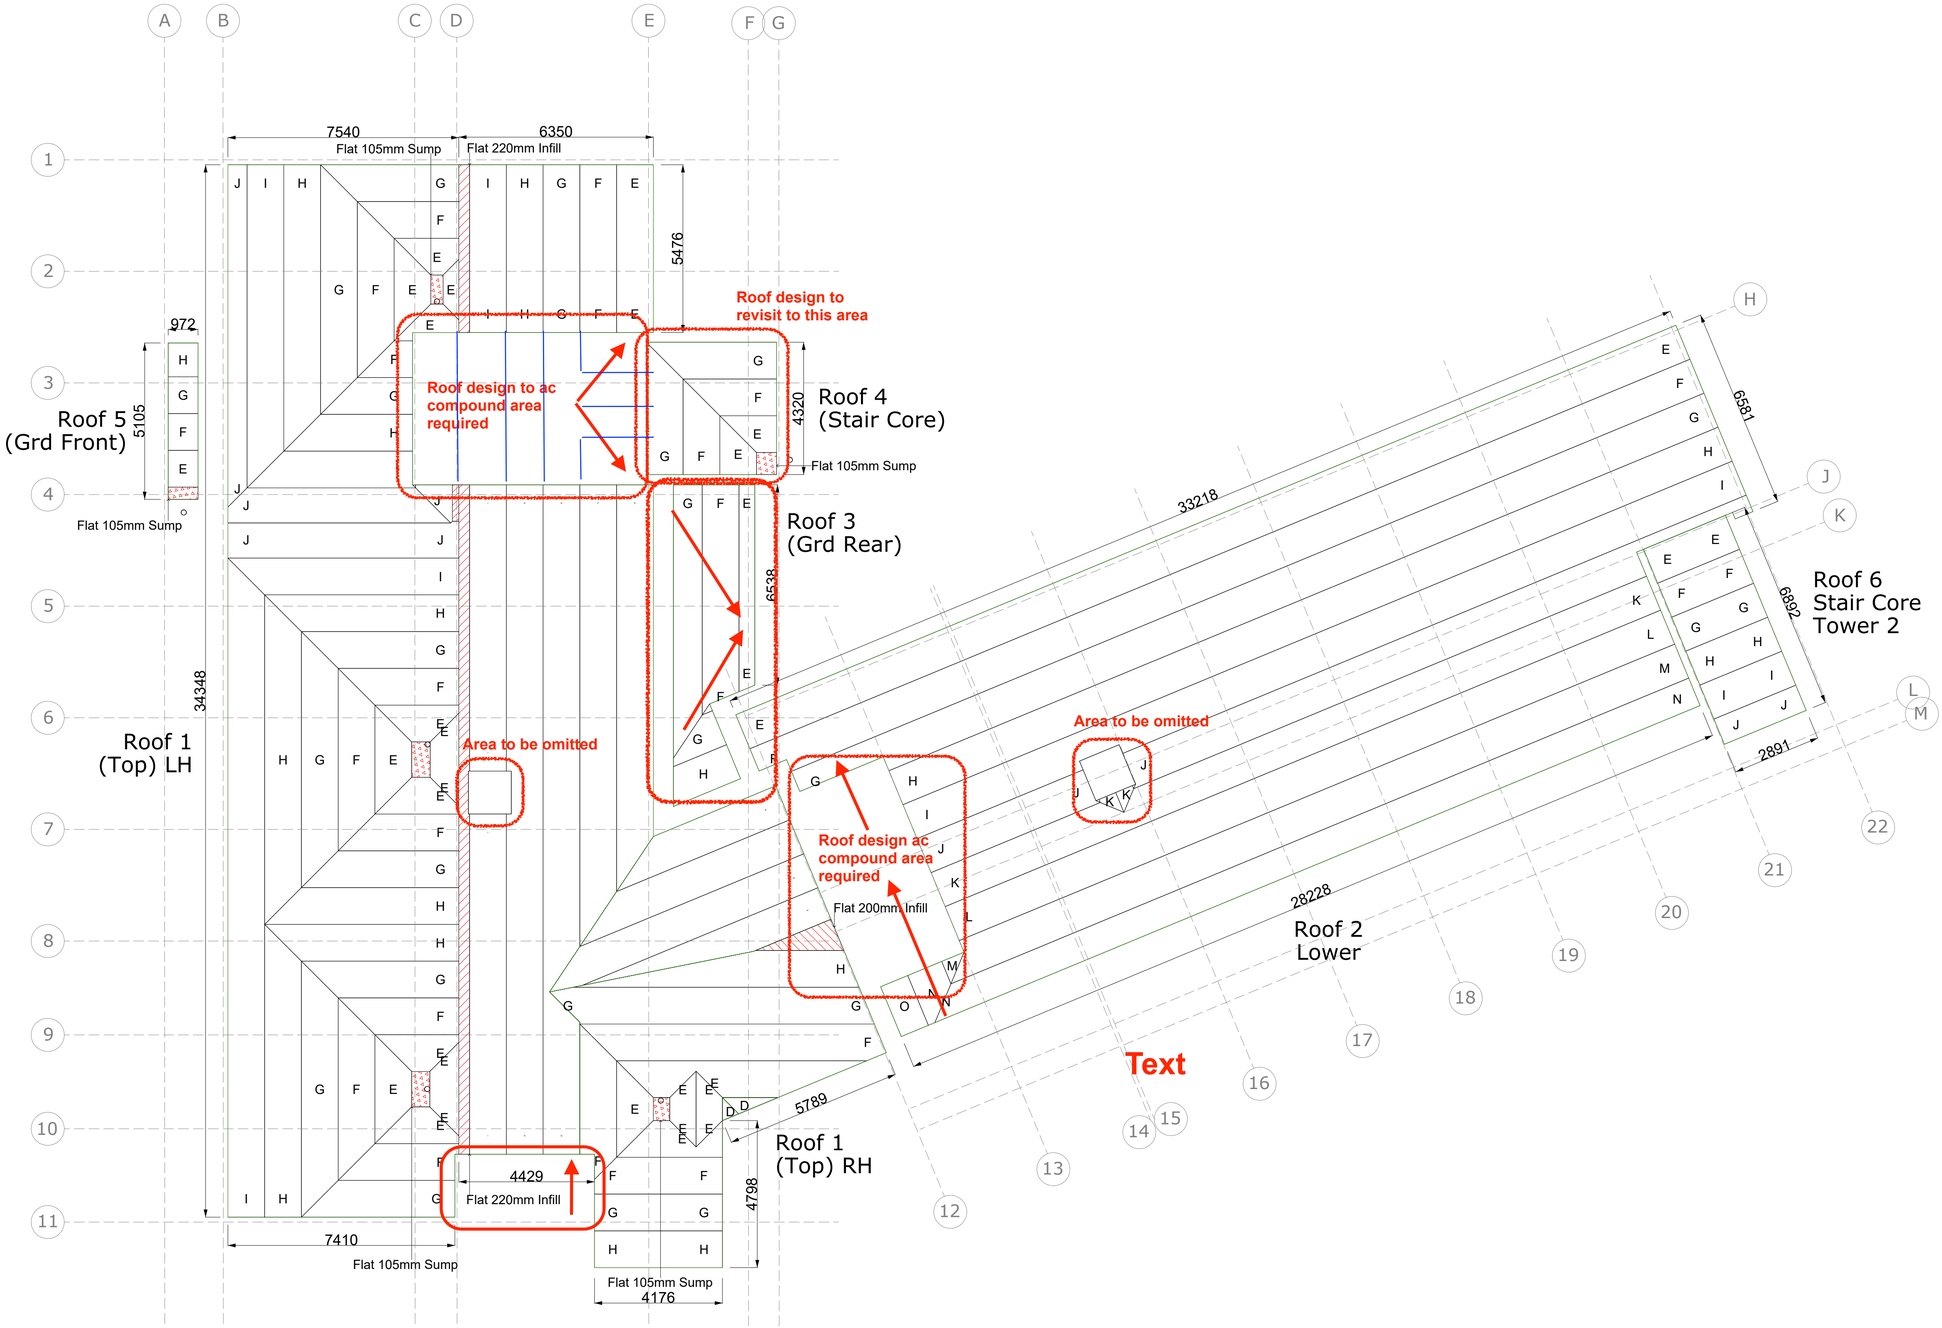

Roof Name Area:	Deck Type	Minimum U Value	Effective U Value	Approximate Net Roof Area (m²)	Approximate Area of Insulation to be Bonded (m²)	Total Insulation Required Inc Waste (m²)
Roof 1 (Top) LH	Timber (18mm)	0.31 W/m² K	0.20 W/m² K	250.95	438.25	507.60
Roof 1 (Top) RH	Timber (18mm)	0.31 W/m² K	0.21 W/m² K	247.61	399.57	440.40
Roof 4 (Stair Core)	Timber (18mm)	0.31 W/m² K	0.22 W/m² K	18.37	27.22	34.80
Roof 3 (Grd Rear)	Timber (18mm)	0.25 W/m² K	0.22 W/m² K	23.65	35.40	48.00
Roof 5 (Grd Front)	Concrete	0.34 W/m² K	0.24 W/m² K	04.96	07.21	08.40
Roof 2 Lower	Timber (18mm)	0.27 W/m² K	0.18 W/m² K	337.54	655.79	682.80
Roof 6 Stair Core Tower 2	Timber (18mm)	0.27 W/m² K	0.20 W/m² K	19.92	32.91	34.80

Tapered Build Up Section - 1 in 60 (Not To Scale)

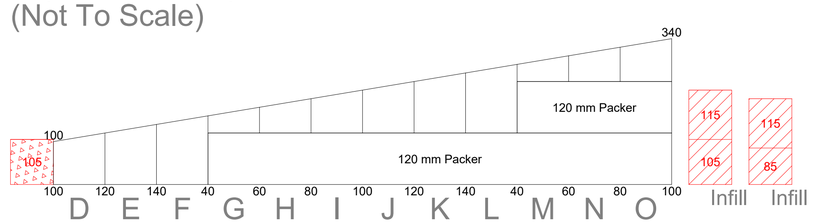

Although this tapered insulation scheme is designed to help remove water from the roof, we cannot guarantee that ponding will not be totally elimated.
Please note that ponding may occur around the flatboard gutter area due to a lack of cross falls.

INSTALLATION NOTES:
1. Contractor to be responsible for checking details and drawing dimensions.
2. Boards are to be laid with their edges tightly butted. Uniform thickness boards should be laid with staggered joints.
To provide a uniform fall it is essential that the deck is even and true. Any features such as hollows, backfalls,
depressions, must be rectified prior to laying the boards.
3. Boards are laid sequentially in accordance with the position code number/letter on the roof layout drawing. Laying of the CTF boards should commence from set out points indicated on the drawing.
4. To avoid error, it is advisable to temporarily position each board prior to bonding.
5. This drawing schedules sufficient material to complete this contract.any additional material will be charged.
6. Insulation to upstands and areas of uniform thickness are not included unless specially stated on this drawing.
7. All cutting to be carried out on site.Offcuts may be required to complete the scheme.
8. Sumps, infills, gutters to be cut to suit by contractor from standard size boards.
9. Perimeter detail, rooflights, sills etc,to be raised if required.
10. If built up felt roofing is specified,board joints should be tapered to prevent the ingress of hot bitumen.

BauderROCK		
D	100 - 120	1 in 60
E	120 - 140	1 in 60
F	140 - 160	1 in 60
G	160 - 180	1 in 60
H	180 - 200	1 in 60
I	200 - 220	1 in 60
J	220 - 240	1 in 60
K	240 - 260	1 in 60
L	260 - 280	1 in 60
M	280 - 300	1 in 60
N	300 - 320	1 in 60
O	320 - 340	1 in 60
Flat	105	
Flat	200	85+115
Flat	220	105+115

Effective Thickness: 180mm

All Dimensions, positions of Rooflights and Outlets are to be checked on site BEFORE the tapered scheme is ordered.

Rev	Date	Notes	By
A	19/10/26	Drawing Issued For Approval & Comment	SB

BAUDER

UK OFFICE
Bauder Limited
70 Landseer Road, Ipswich,
Suffolk IP3 0DH,
England.
Tel: +44 (0)1473 257671
Fax: +44 (0)1473 230761
Email: technical@bauder.co.uk
bauder.co.uk

IRELAND OFFICE
Bauder Limited
ODuffy Centre, Cross Lane,
Carrickmacross, Co.
Monaghan,
Ireland.
Tel: +353 (0)42 9692 333
Fax: +353 (0)42 9692 839
Email: technical@bauder.ie
bauder.ie

Contractor to be responsible for checking this scheme against architects drawings/site requirements and to advise Bauder immediately of any discrepancies. Orders placed against this drawing reference assume approval of this scheme. Any materials required over and above the quantities given, will be charged accordingly.

Contract Name:
Exeter St Davids Premier Inn

BauderROCK TAPER SCHEME

Contract No:	B265324		
Drawing No:	RLTF - 001	Ref:	18930_26.01
Material:	Tapered BauderROCK	Fall:	1 in 60
Scale:	1:100	Date:	15/10/2026
Roof Area:	904 m²		
Designed to Drawing No:	-AXA-ZZ-RF-D-A-1000 SCOPE OF WORKS ROOF PLAN (003)		

© Copyright:- This drawing is subject to copyright. No part of this document may be reproduced in any form, without the permission of BAUDER LTD.